

Quotiq sample subcontractor package

Marked-up subcontractor sheet - Partitions - Page 1

Scaled to fit page. Use listed quantities and verify dimensions/site conditions before fabrication or installation.


Legend and quantities



Subcontractor scope: partitions only

- 1** 100mm 40kg drywall
10.9 m2
- 2** 100mm 80kg drywall
28.2 m2
- 3** Single-glazed, framed
28.2 m2
- 4** Fire-rated partition
11.0 m2



Package outline

- Page 1: Marked-up subcontractor sheet
- Page 2: Untouched original reference drawing
- Original source page: 1

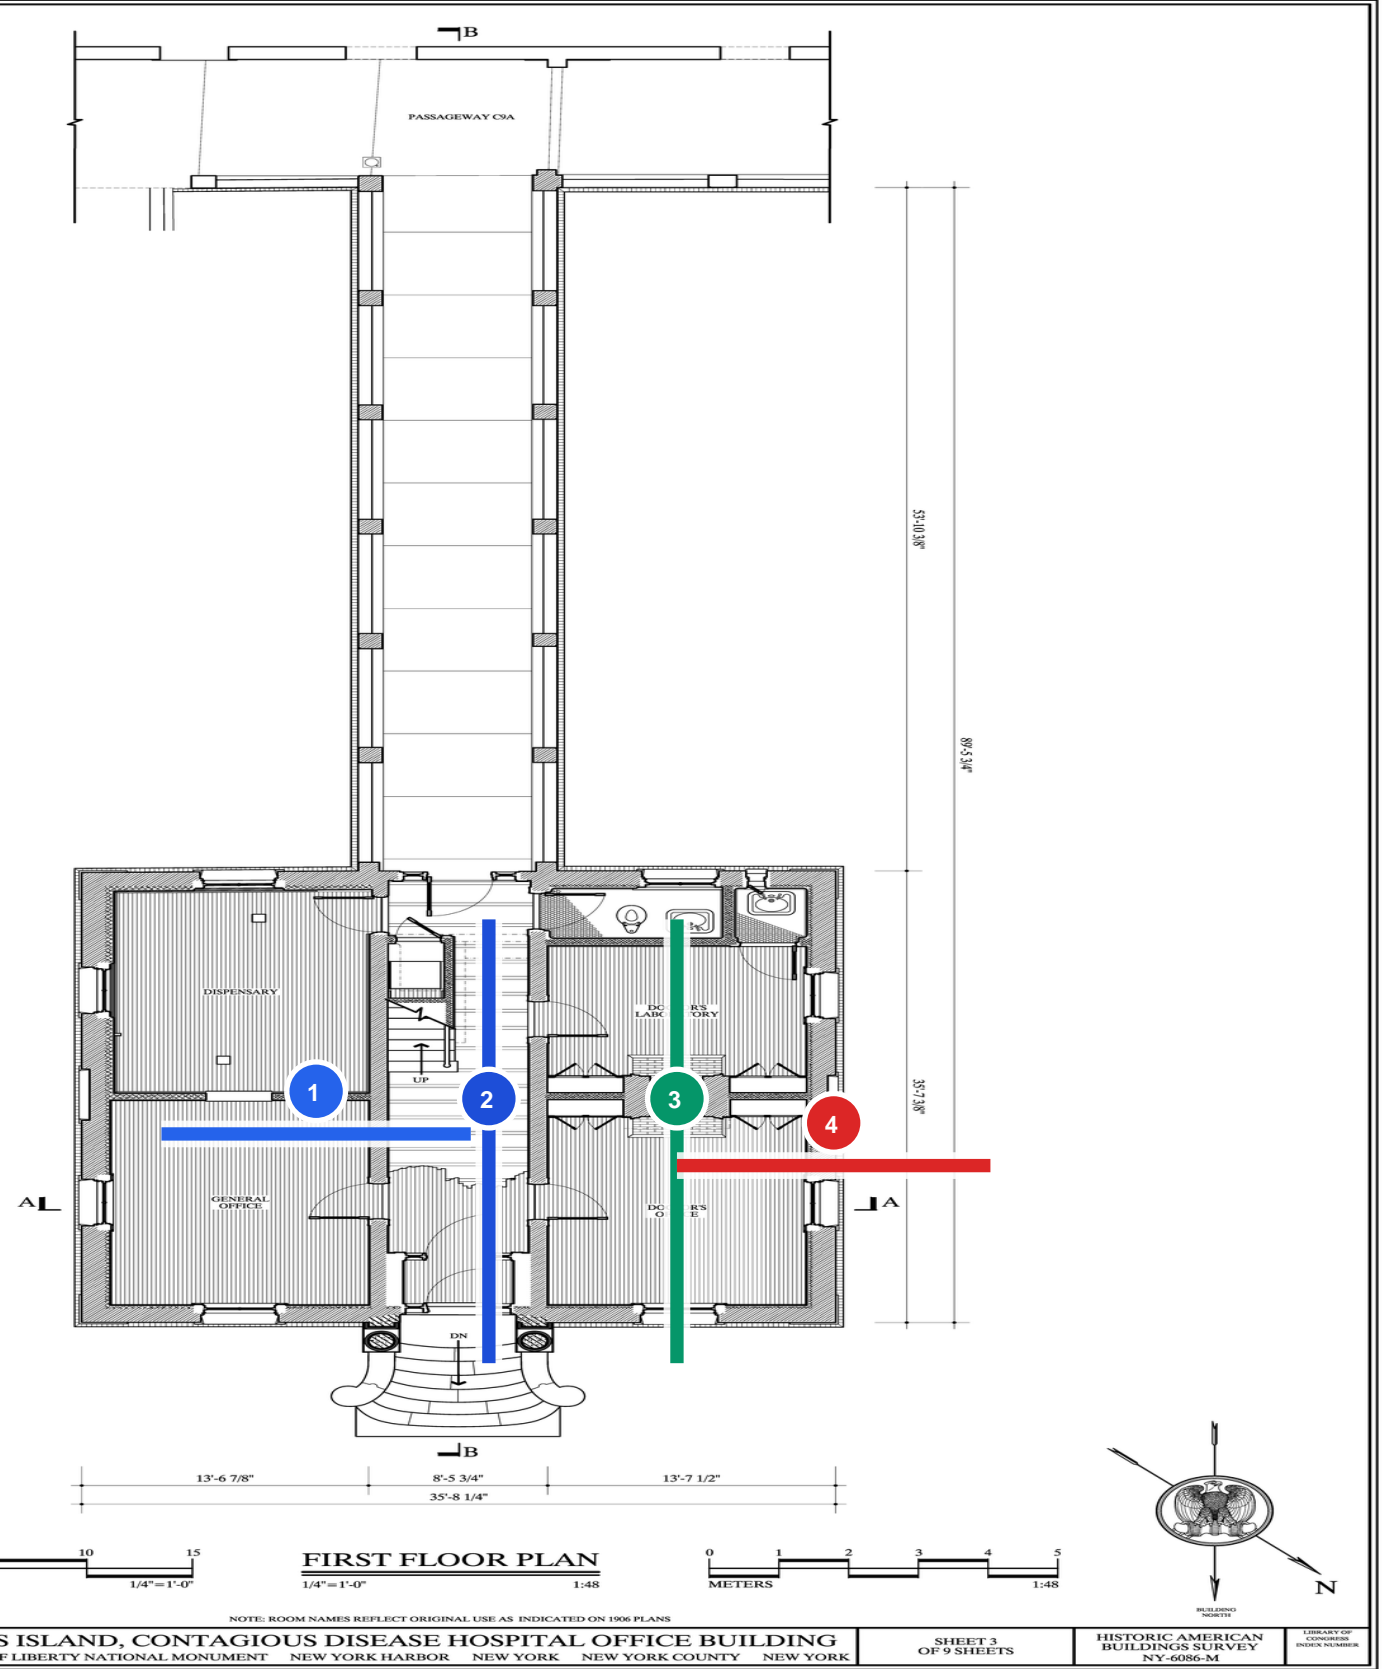

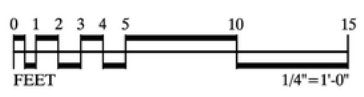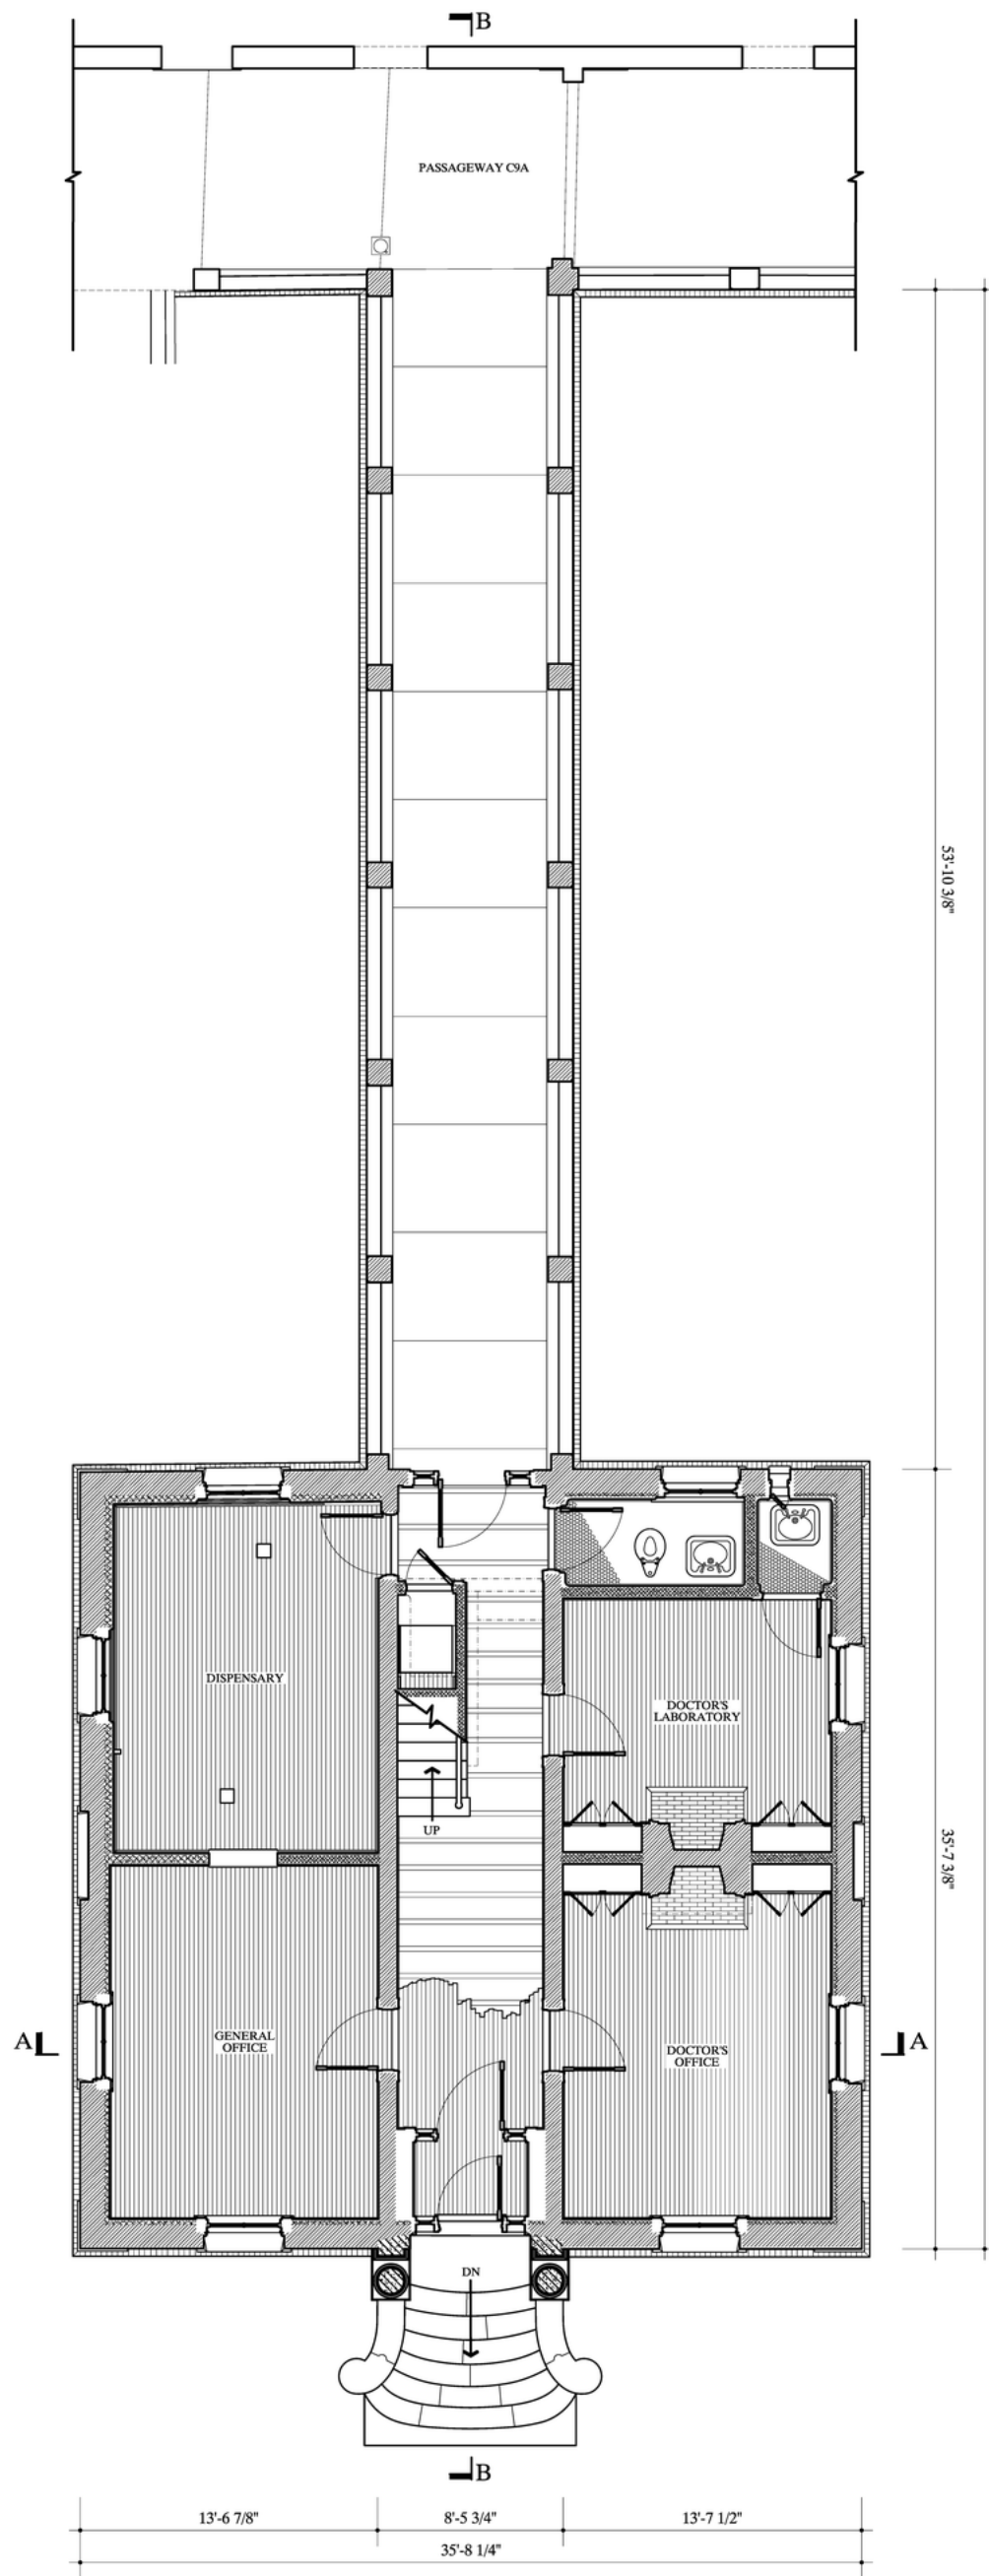

FIRST FLOOR PLAN
1/4" = 1'-0" 1:48

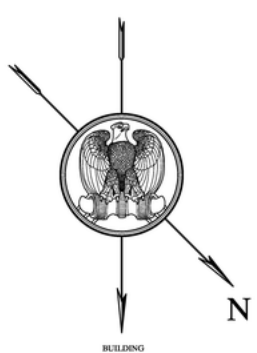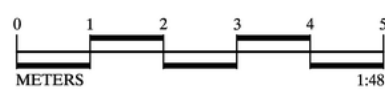

DRAWN BY: LUIS PIERALDI / PAUL DAVIDSON

NOTE: ROOM NAMES REFLECT ORIGINAL USE AS INDICATED ON 1906 PLANS

ELLIS ISLAND DOCUMENTATION PROJECT, 2009
NATIONAL PARK SERVICE
UNITED STATES DEPARTMENT OF THE INTERIOR

ELLIS ISLAND, CONTAGIOUS DISEASE HOSPITAL OFFICE BUILDING
STATUE OF LIBERTY NATIONAL MONUMENT NEW YORK HARBOR NEW YORK NEW YORK COUNTY NEW YORK

SHEET 3
OF 9 SHEETS

HISTORIC AMERICAN
BUILDINGS SURVEY
NY-6086-M

LIBRARY OF
CONGRESS
INDEX NUMBER